


RECORD OF SURVEY NO. 32-14

IN THE NE 1/4 OF THE NE 1/4 OF SEC 16, T5N,
R25E, MDB&M.

SCALE: 1" = 50'

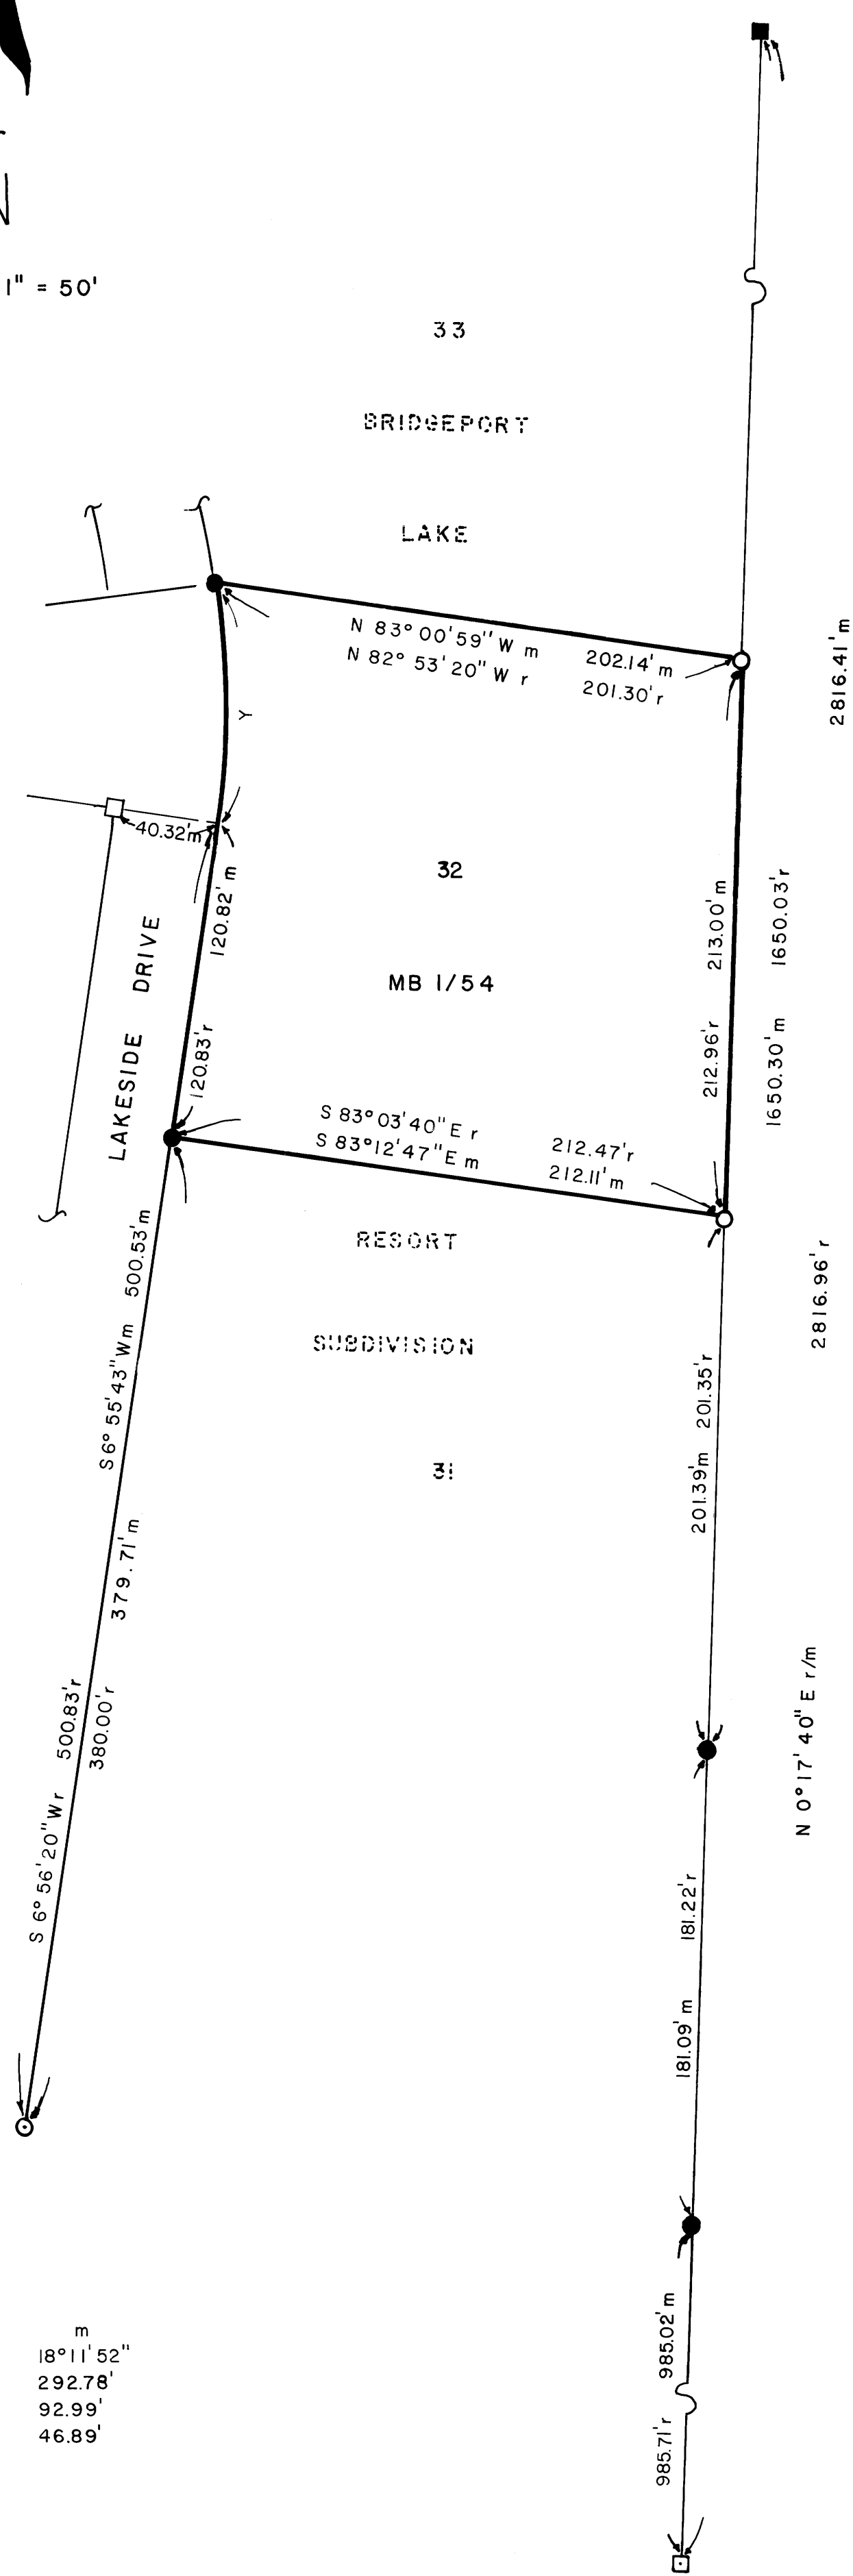

Curve Data:
Y
Δ = 16°46'50" 18°11'52"
R = 320.00' 292.78'
L = 93.72' 92.99'
T = 47.20' 46.89'

RECORDER'S CERTIFICATE

Filed this 24 day of June, 1980, at 1:20 p.m. in Book 1 of Record Survey at page 52, at the request of Walter F.L. Brown.

County Recorder

SURVEYOR'S CERTIFICATE

This map correctly represents a survey made by me or under my direction in conformance with the requirements of the Land Surveyors Act at the request of Walter F.L. Brown in November 1979.

County Surveyor

COUNTY SURVEYOR'S CERTIFICATE

This map has been examined for conformance with the requirements of the Land Surveyors Act this 24 day of June, 1980.

County Surveyor

BASIS OF BEARINGS:

N 0°17'40"E, the east line of Section 16 as recorded in M.B. 1/54.

LEGEND:

- Found 2" diameter I.P. and tag 9/10 per M.B. 1/54.
- Found 6"x6" concrete highway monument.
- Found 2"x2" H&T. Replaced with 1" diameter I.P. & Tag R.C.E. 27104.
- Set 1" diameter I.P. & Tag R.C.E. 27104.
- Found 1" diameter I.P. & Tack per M.B. 1/54.
- Found 2"x2" H&T. Accepted per M.B. 1/54.
- r Based on record information.
- m Based on measured information.
- r/m Based on record and measured information.

RS Book 1 Page 53